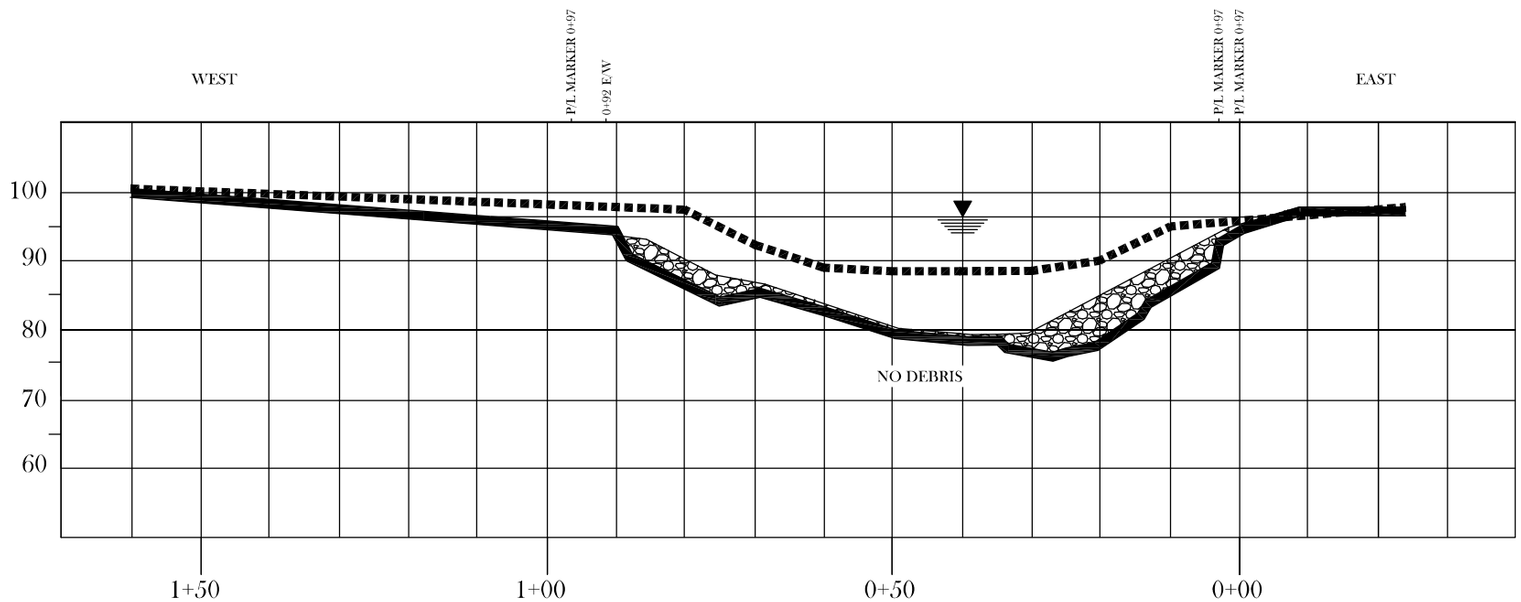

1 / C101 **PROFILE**

SCALE: NOT TO SCALE

NOTES: SEPT 2006
ASBUILT GROUT BAG STABILIZATION 09 SEPT.

NOTES: 2006
DATE OF INSPECTION: 04 SEPT. 2006

NOTES: 06 APRIL 2016
B.M: NAIL IN POWER POLE (EAST SIDE) APPLIES TO OTHER SHEET

NOTES: 2003
DATE OF INSPECTION: 10 APRIL 2003

NEW ELEVATION READING

NOTES: 1998
DATE OF INSPECTION: 13 NOV. 1998
PT. A: TRANSIT LOCATION (EAST BANK)
B.M. #1: NAIL IN POWER POLE (EAST BANK) ELEV 0.00 (ASSUMED)
ALL STATIONING DEVELOPED ALONG ROUTE OF PIPELINE

REV:	ZONE:	REVISION NOTES:	REVISIONS

DESIGNED BY:
DRAWN BY: BRIAN COLLETTE
REVIEW BY:
APPROVED BY:
SIGN & DATE:

CROFTON Diving Corporation
Construction - Diving - Technical Services
16 Harper Avenue
Portsmouth, Virginia 23707
Tele (757) 397-1131
Fax (757) 397-8693
www.croftondiving.com

CUSTOMER:
CHESAPEAKE UTILITIES CORP.

PROJECT TITLE:
WICOMICO RIVER
SALISBURY, MD

PROFILE

JOB NO: 16-8418

CONTRACT NO: N/A

SCALE: AS NOTED

REV:

DWG SIZE: B

DATE:7/28/16

SHEET: SK1